

Interpretation of City of Minneapolis Zoning Code

Shoreland Overlay District:  
300' from the river

Grading and filling: more than 10 CY needs an Erosion Control Permit

Removal of vegetation needs to be approved

Mississippi River Corridor Critical Area Overlay District:

Urban Mixed (UM) MRCCA District  
UM has to have 10% protected open space or green infrastructure in place


Vegetation Permit for tree removal

Water quality impact zone = 50' from OHWL of the river

10 CY of material or impacting >1,000 SF within the water quality impact zone needs a Land Alteration Permit

Prove that changes will improve erosion issues


Multipurpose trails and sidewalks are exempt from stormwater permit impervious surface rules if there is down gradient vegetation or a filter strip that is at least five (5) feet wide.

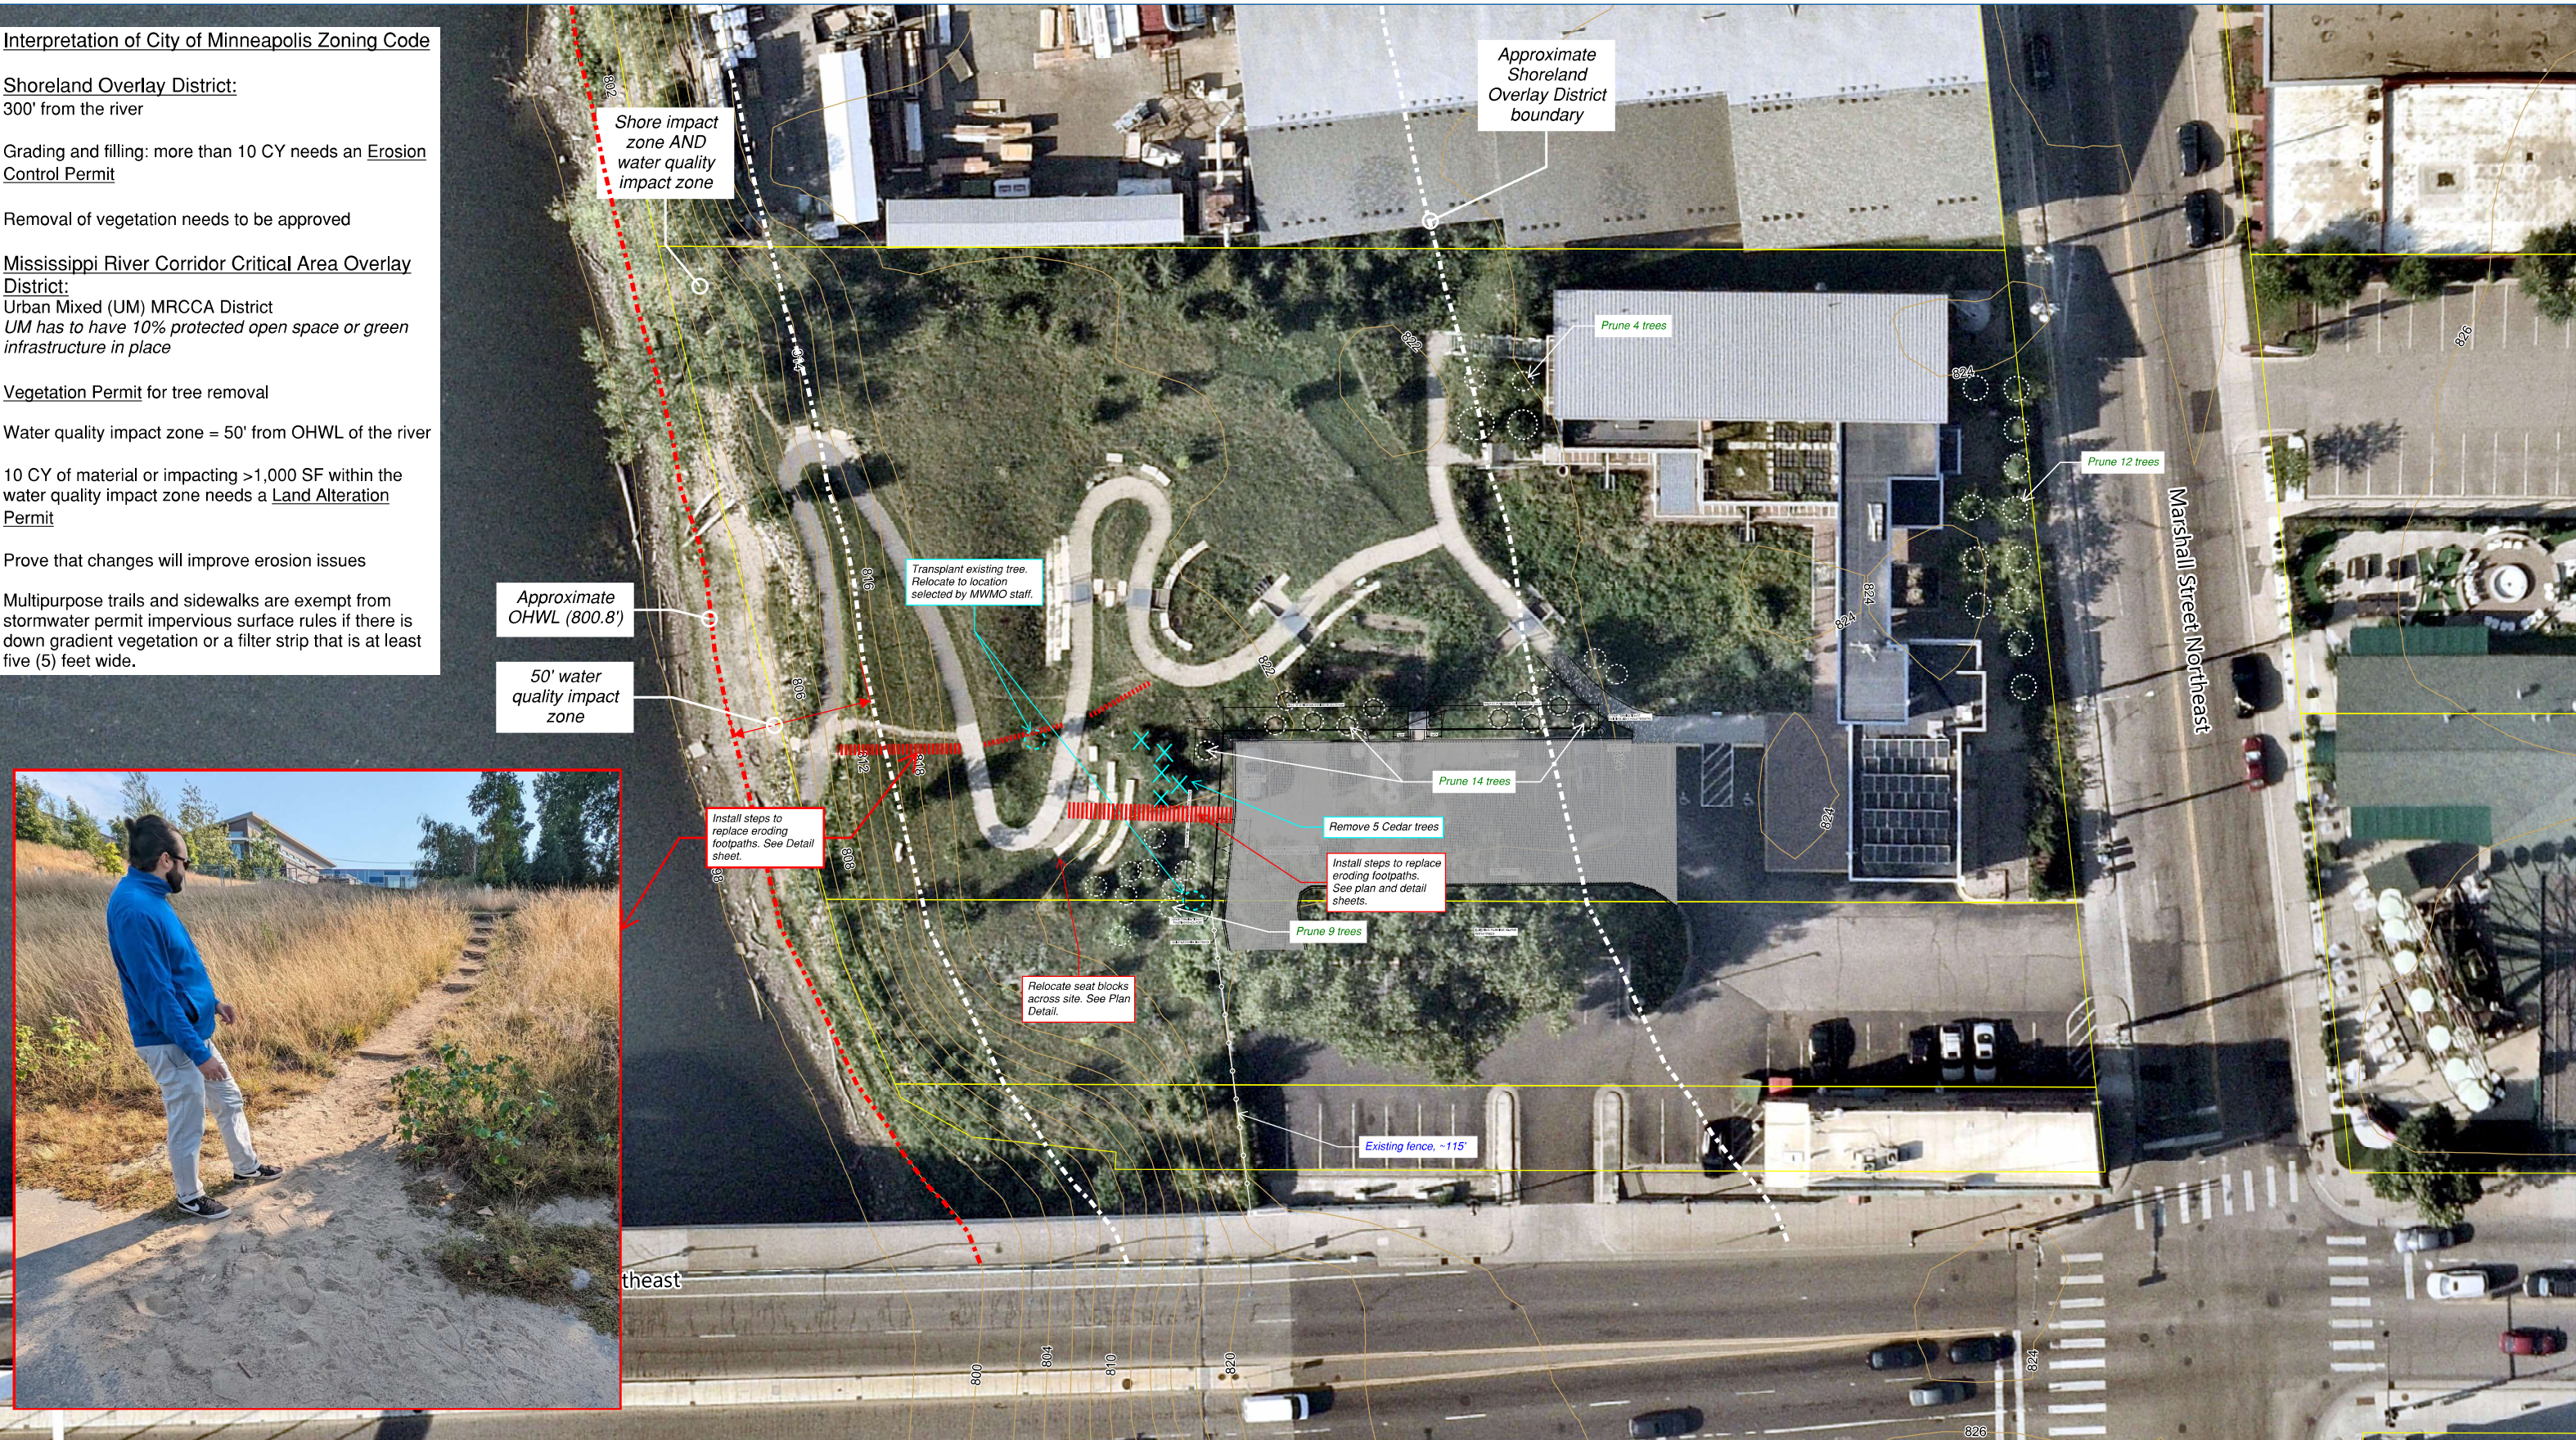

2 Foot Elevation Contours

Parcel Boundaries

Imagery: NearMap, 2023

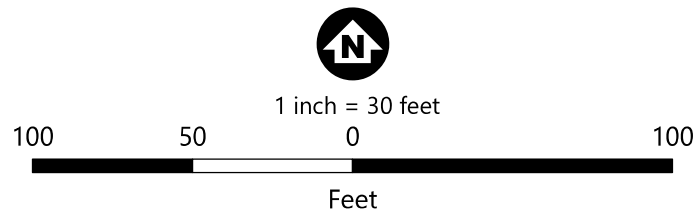


Preliminary Permitting Analysis  
February 2024

Mississippi Watershed  
Management Organization

FIGURE 1



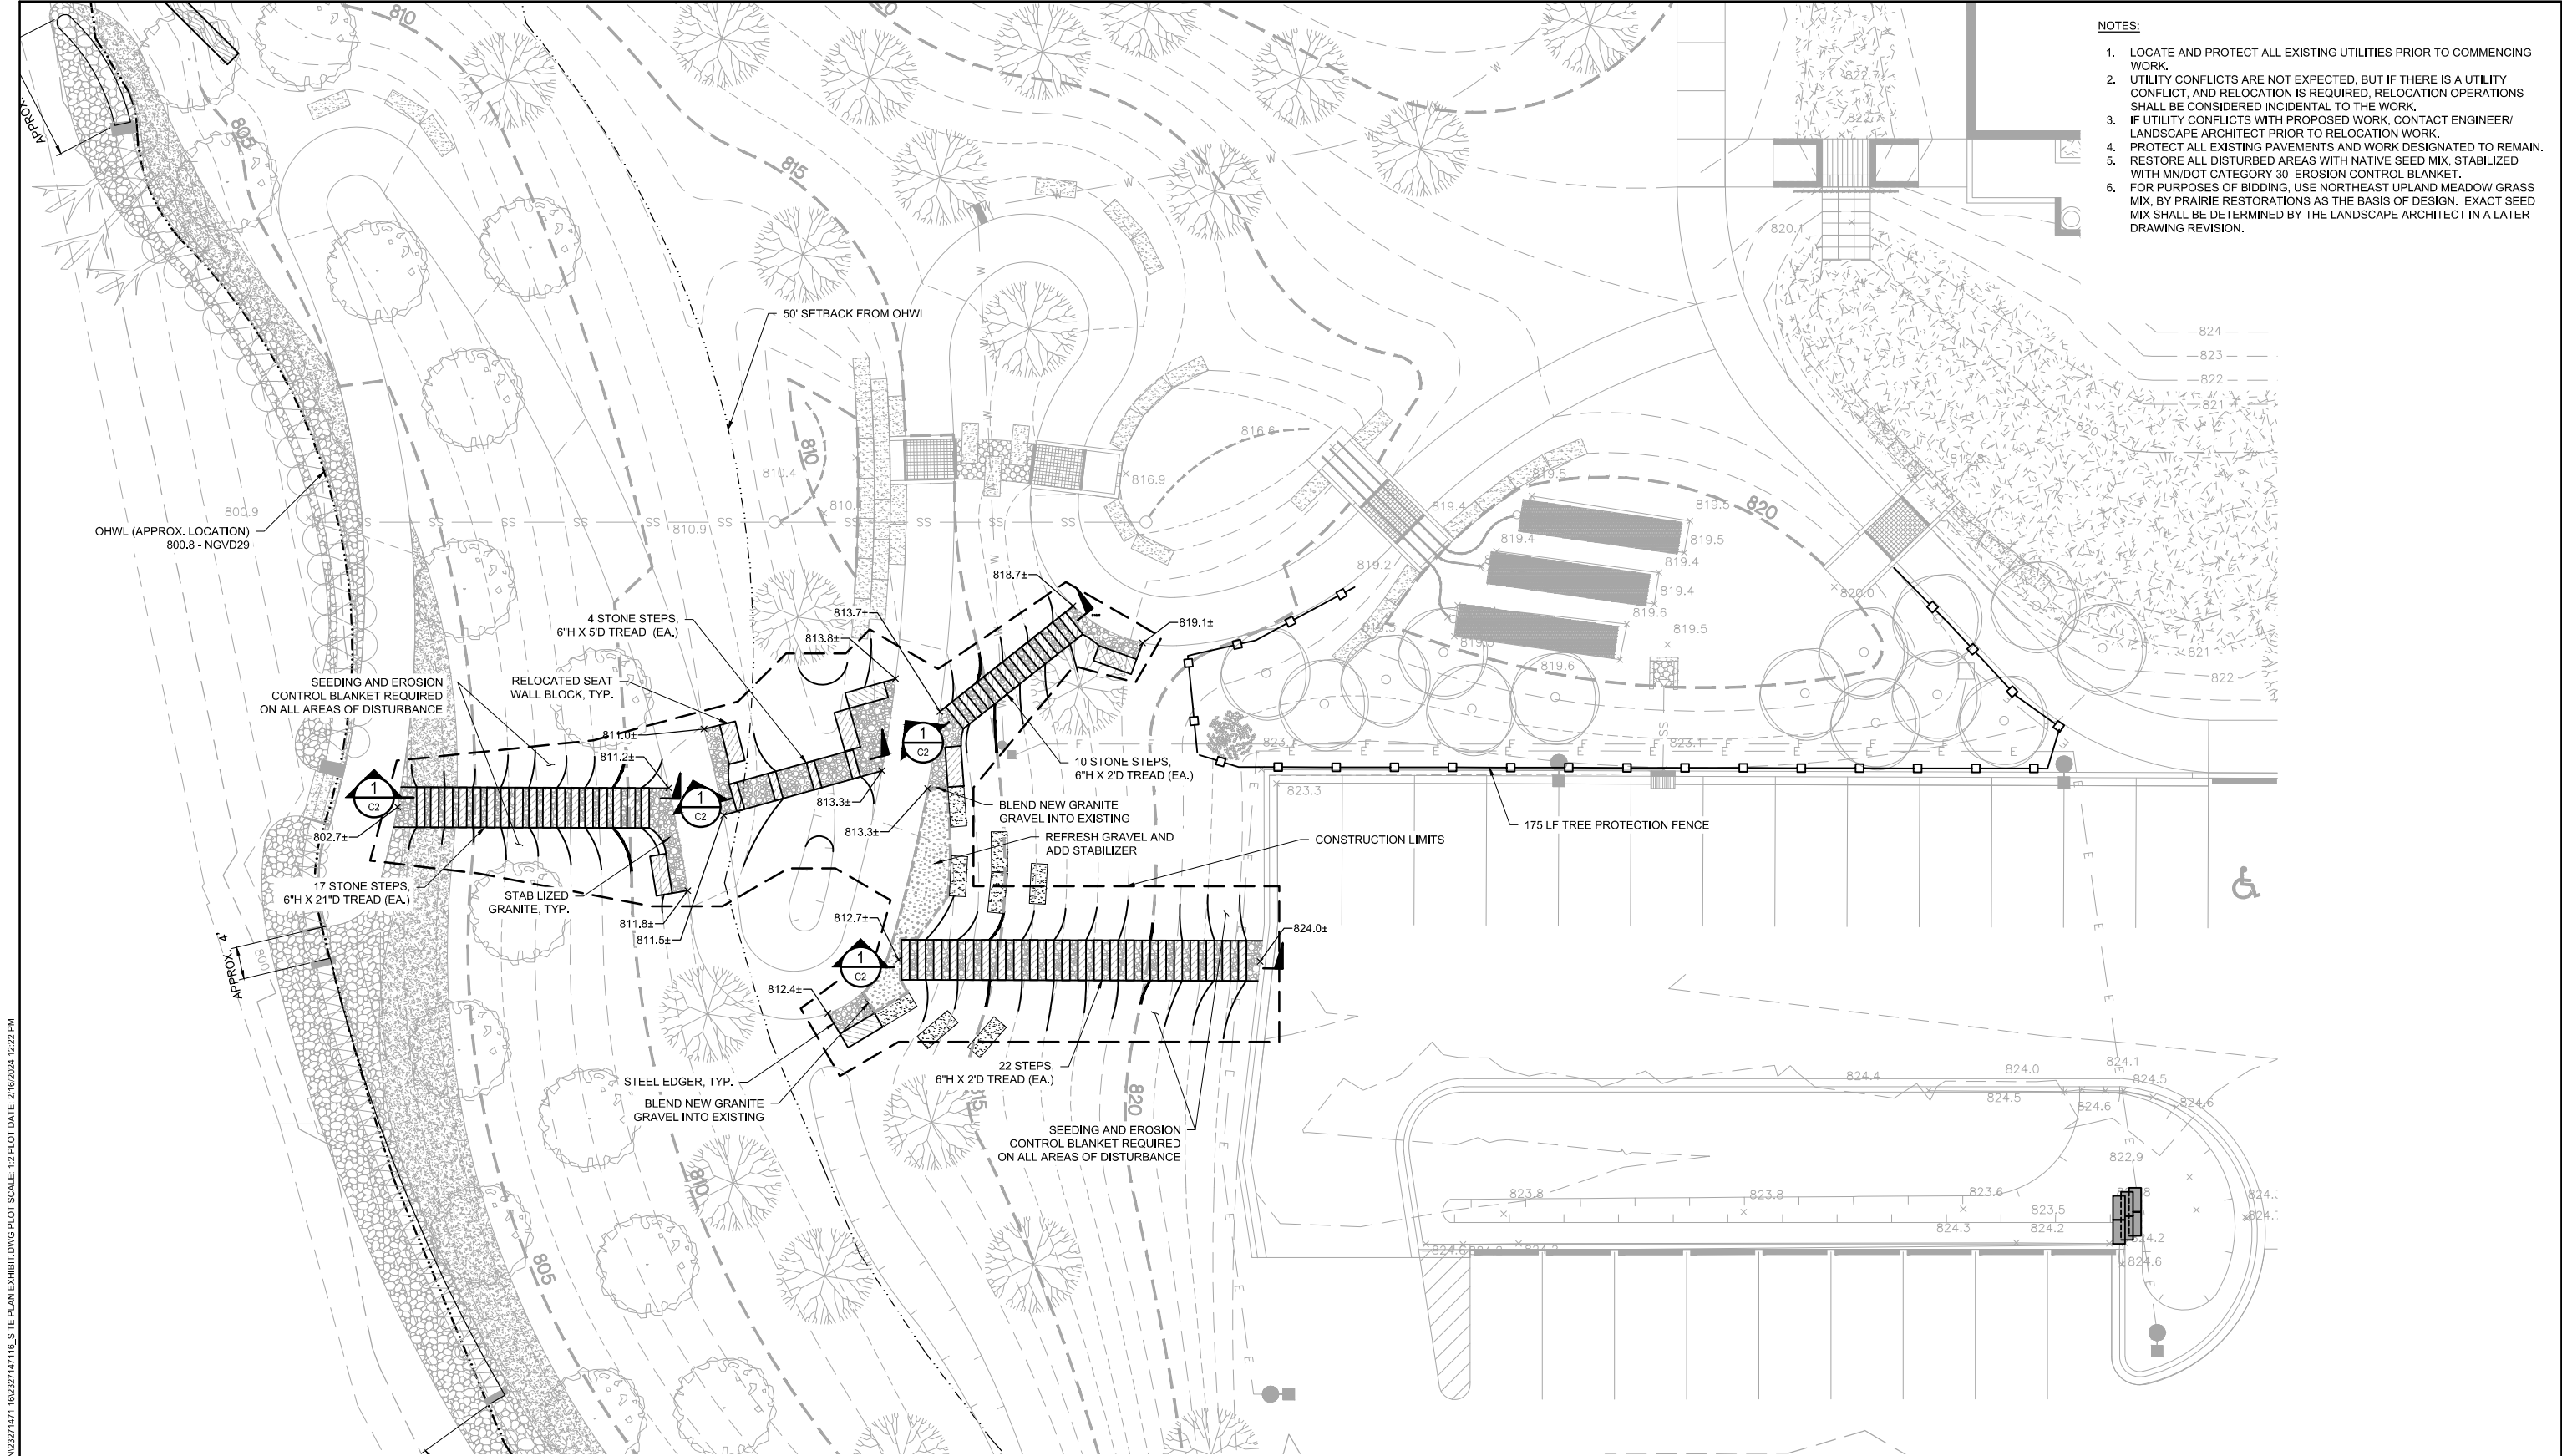


- NOTES:
1. LOCATE AND PROTECT ALL EXISTING UTILITIES PRIOR TO COMMENCING WORK.
  2. UTILITY CONFLICTS ARE NOT EXPECTED, BUT IF THERE IS A UTILITY CONFLICT, AND RELOCATION IS REQUIRED, RELOCATION OPERATIONS SHALL BE CONSIDERED INCIDENTAL TO THE WORK.
  3. IF UTILITY CONFLICTS WITH PROPOSED WORK, CONTACT ENGINEER/ LANDSCAPE ARCHITECT PRIOR TO RELOCATION WORK.
  4. PROTECT ALL EXISTING PAVEMENTS AND WORK DESIGNATED TO REMAIN.
  5. RESTORE ALL DISTURBED AREAS WITH NATIVE SEED MIX, STABILIZED WITH MN/DOT CATEGORY 30 EROSION CONTROL BLANKET.
  6. FOR PURPOSES OF BIDDING, USE NORTHEAST UPLAND MEADOW GRASS MIX, BY PRAIRIE RESTORATIONS AS THE BASIS OF DESIGN. EXACT SEED MIX SHALL BE DETERMINED BY THE LANDSCAPE ARCHITECT IN A LATER DRAWING REVISION.

CADD USER: DEREK J. SEIFERT FILE: M:\DESIGN\23271471\_192327147116\_SITE PLAN EXHIBIT.DWG PLOT SCALE: 1/2"=1'-0" PLOT DATE: 2/16/2024 12:22 PM



PRELIMINARY DRAFT  
NOT FOR CONSTRUCTION

					I HEREBY CERTIFY THAT THIS PLAN, SPECIFICATION, OR REPORT WAS PREPARED BY ME OR UNDER MY DIRECT SUPERVISION AND THAT I AM A DULY LICENSED LANDSCAPE ARCHITECT UNDER THE LAWS OF THE STATE OF MINNESOTA.					CLIENT PERMIT BID CONSTRUCTION RECORD					BARR PROJECT OFFICE: BARR ENGINEERING CO. 4300 MARKETPOINTE DRIVE SUITE 200 MINNEAPOLIS, MN 55435					Scale AS SHOWN Date 02/06/2024 Drawn DJS2 Checked --- Designed BARR Approved ---					MISSISSIPPI WATERSHED MANAGEMENT ORGNIZATION MINNEAPOLIS, MN					TRAIL & SITE IMPROVEMENTS MWMO HEADQUARTERS					BARR PROJECT No. 23/27-1471.17				
					PRINTED NAME					RELEASED TO/ FOR					Corporate Headquarters: Minneapolis, Minnesota Ph: 1-800-632-2277 Fax: (952) 832-2601 www.barr.com															SITE PLAN					CLIENT PROJECT No.				
NO. BY CHK. APP. DATE					REVISION DESCRIPTION					DATE RELEASED																									DWG. No. C1				
																																			REV. No. -				

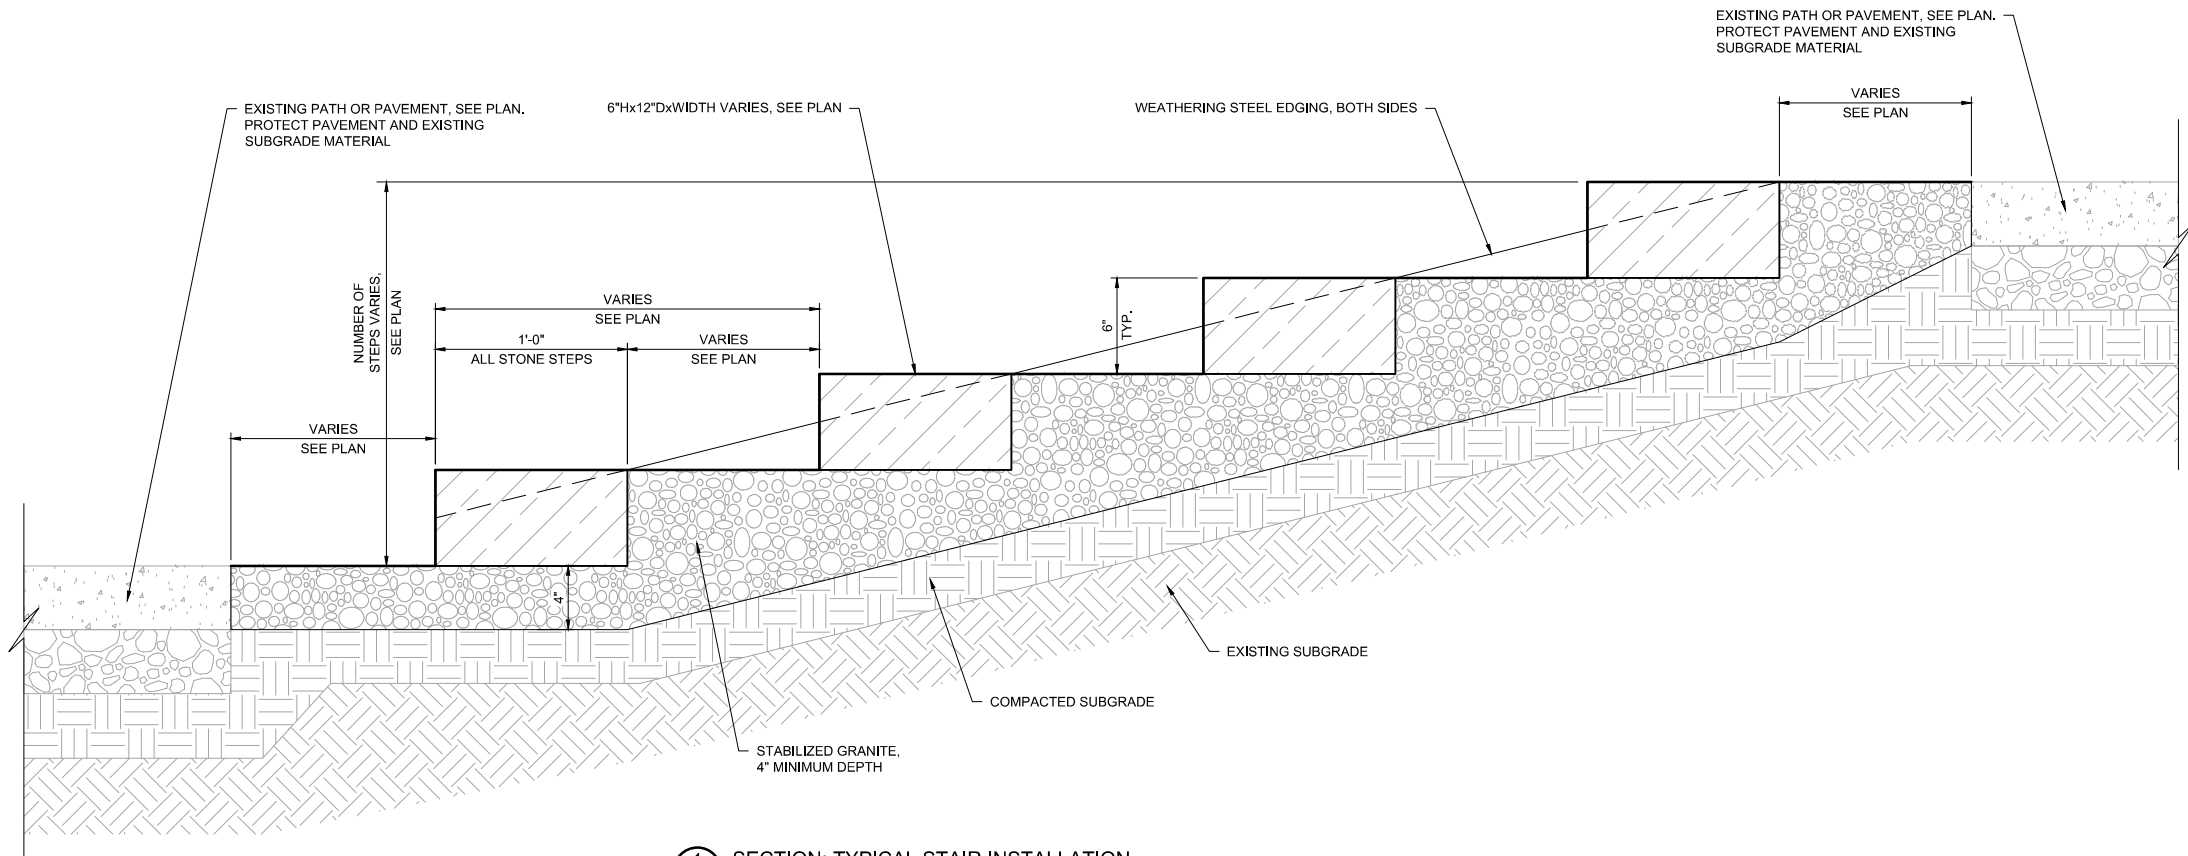

1 SECTION: TYPICAL STAIR INSTALLATION  
NOT TO SCALE

PRELIMINARY DRAFT  
NOT FOR CONSTRUCTION

CADD USER: DEREK J. SEIFERT FILE: M:\DESIGN\23271471\_192327147116\_DETAILS.DWG PLOT SCALE: 1/2 PLOT DATE: 2/6/2024 12:32 PM

--	--	