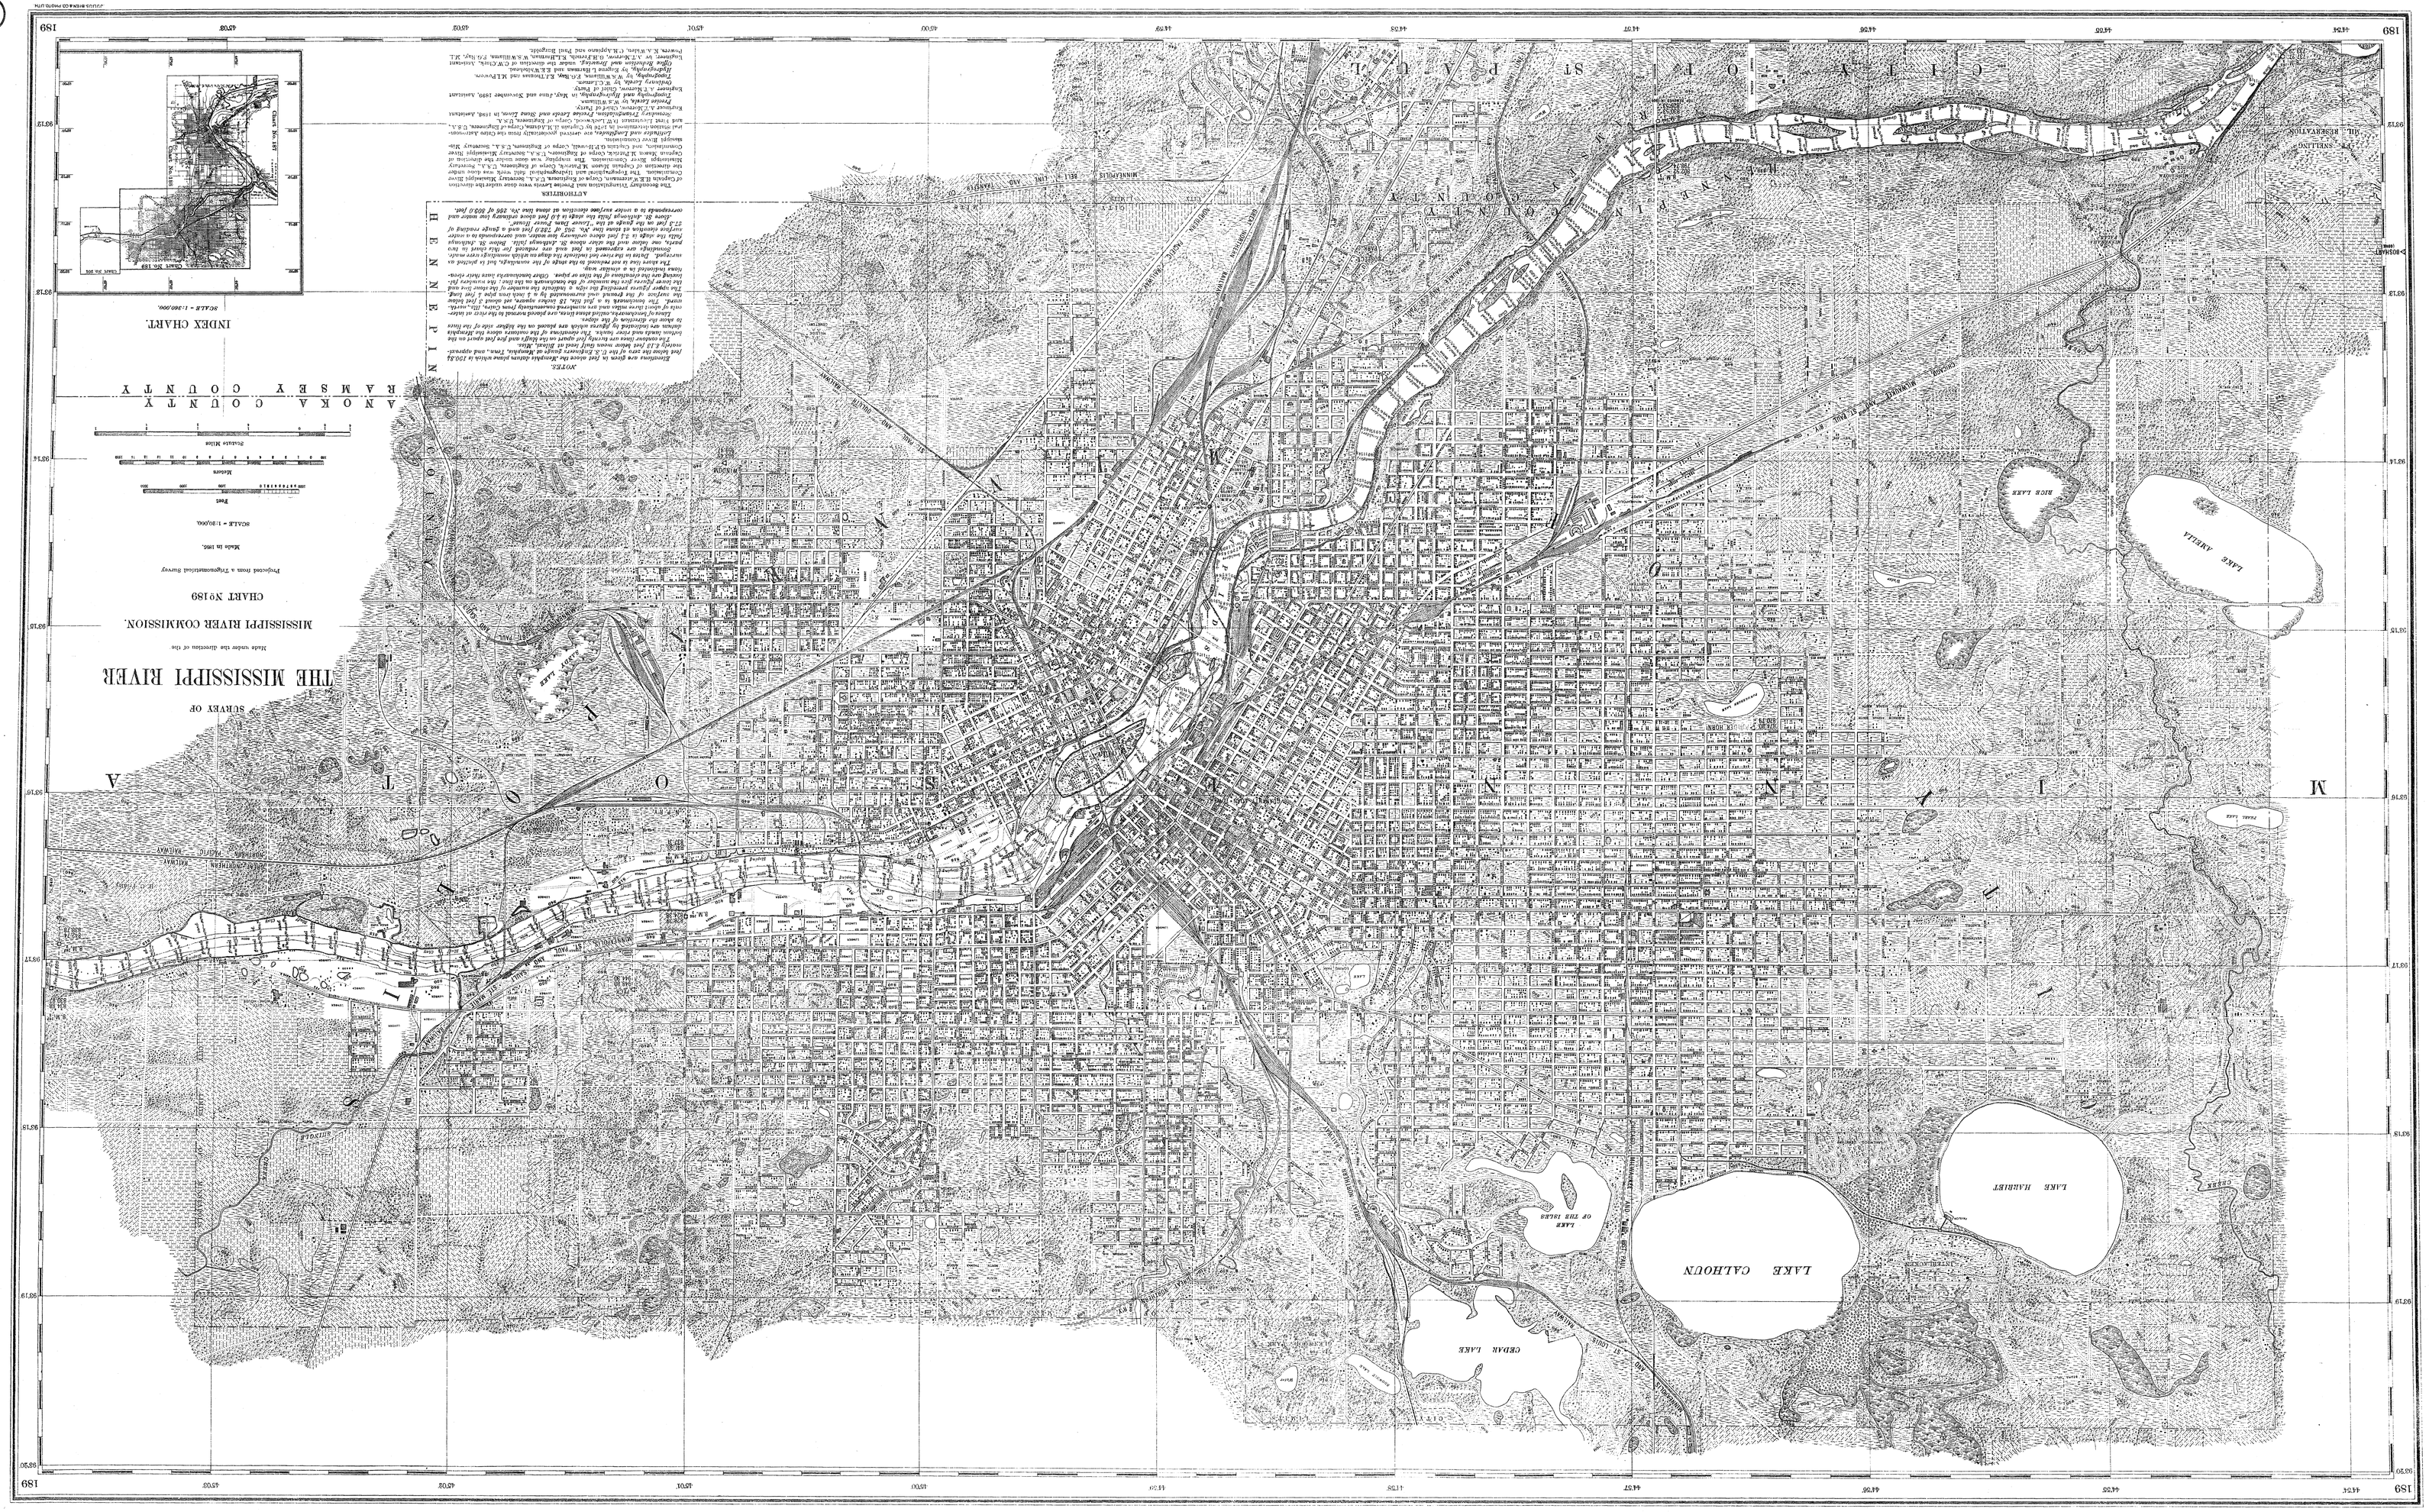RECORD COPY
PLEASE RETURN TO MAP FILE